


SURVEYOR DID NOT ABSTRACT FOR EASEMENTS OR OWNERSHIP.
 SURVEY PREPARED WITHOUT BENEFIT OF TITLE COMMITMENT.
 BEARINGS ARE REFERRED TO THE TEXAS COORDINATE SYSTEM
 OF 1983, CENTRAL ZONE.
 SEE FIELD NOTES OF THIS DATE.
 © = 3/8" IRON ROD SET FOR CORNER TOPPED WITH A 1" RED PLASTIC
 CAP STAMPED "SAMSON 1915".

LINE	BEARING	DISTANCE
L1	S 85°12'26" W	599.97
L2	S 70°52'07" W	81.73
L3	N 86°46'44" W	270.71
L4	S 84°29'12" W	382.08
L5	S 89°26'58" W	186.14
L6	N 84°02'06" W	77.15


DANIEL RALSTIN
 100 ACRES
 1529/67

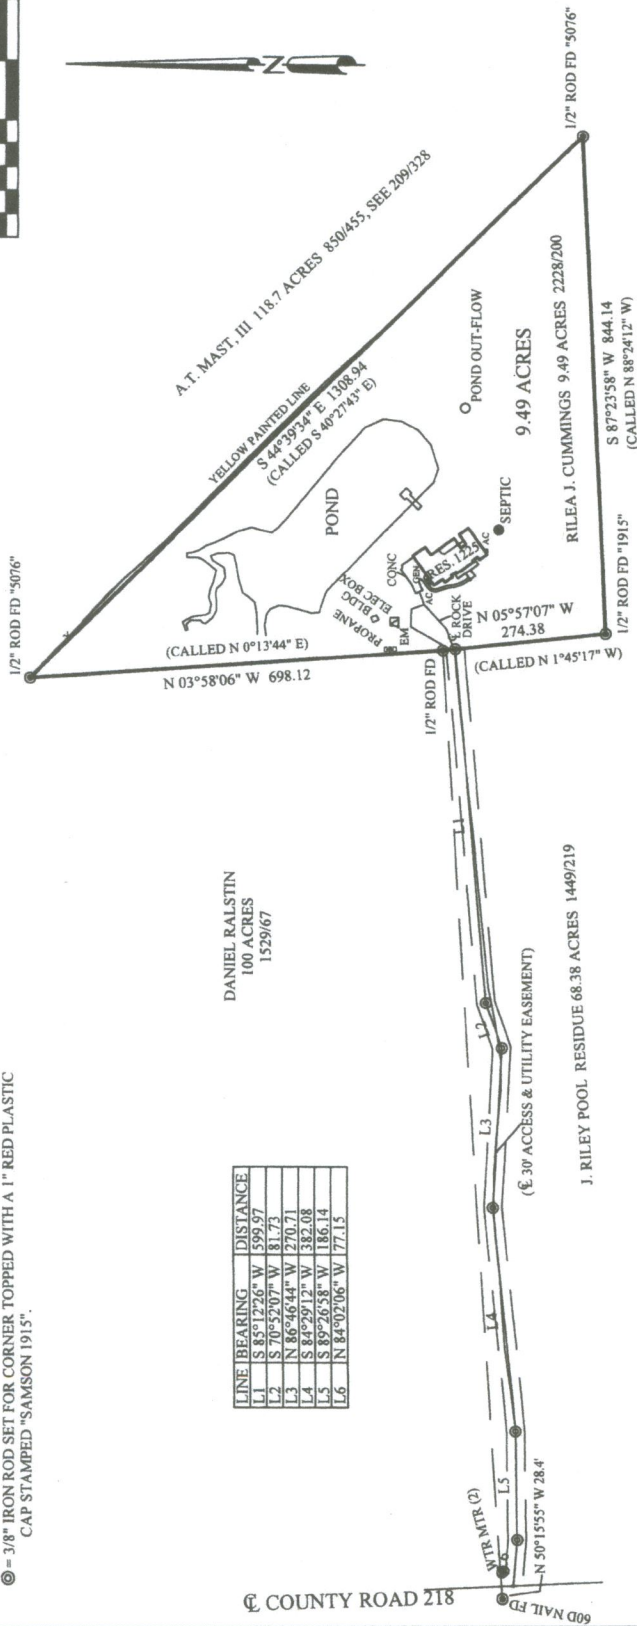

J. RILEY POOL RESIDUE 68.38 ACRES 1449/219

SURVEYED FOR	
RILEA J. CUMMINGS	
N. T. SAMSON & ASSOCIATES <small>FIELD NUMBER 2089/328</small>	
1001 PARK STREET <small>MACOGDOCHES, TEXAS 75061 PHONE (214) 564-4001 FAX (214) 564-2982</small>	
MIGUEL GALAN SURVEY, A-226, MACOGDOCHES COUNTY, TEXAS	
NO.	DATE
REVISIONS	DATE: 1/27/2020
REMARKS	SCALE: 1" = 200'
	JOB NO: 508/154
	SHEET NO. 1 OF 1

I, Tommy Findelsen, a duly Registered Professional Land Surveyor for the State of Texas, do hereby state that the above plat was prepared from a survey made by me on the ground the 27th day of March, 2020. USE OF THIS SURVEY FOR ANY OTHER PURPOSE OR BY OTHER PARTIES SHALL BE AT THEIR RISK AND THE UNDERSIGNED IS NOT RESPONSIBLE TO OTHERS FOR ANY LOSS RESULTING THEREFROM. IF THIS COPY IS NOT SIGNED IN RED INK IT SHOULD BE ASSUMED TO BE AN UNLICENSED COPY AND CONTAIN UNAUTHORIZED MATERIAL.

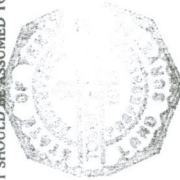

Tommy Findelsen
 Tommy Findelsen, RPLS No. 1915